

C:\Users\collins\Documents\3100 Valpo Science Central 2015\_collins\architects.com.rvt  
12/4/2017 8:52:02 AM

F


E

D

C


B

A

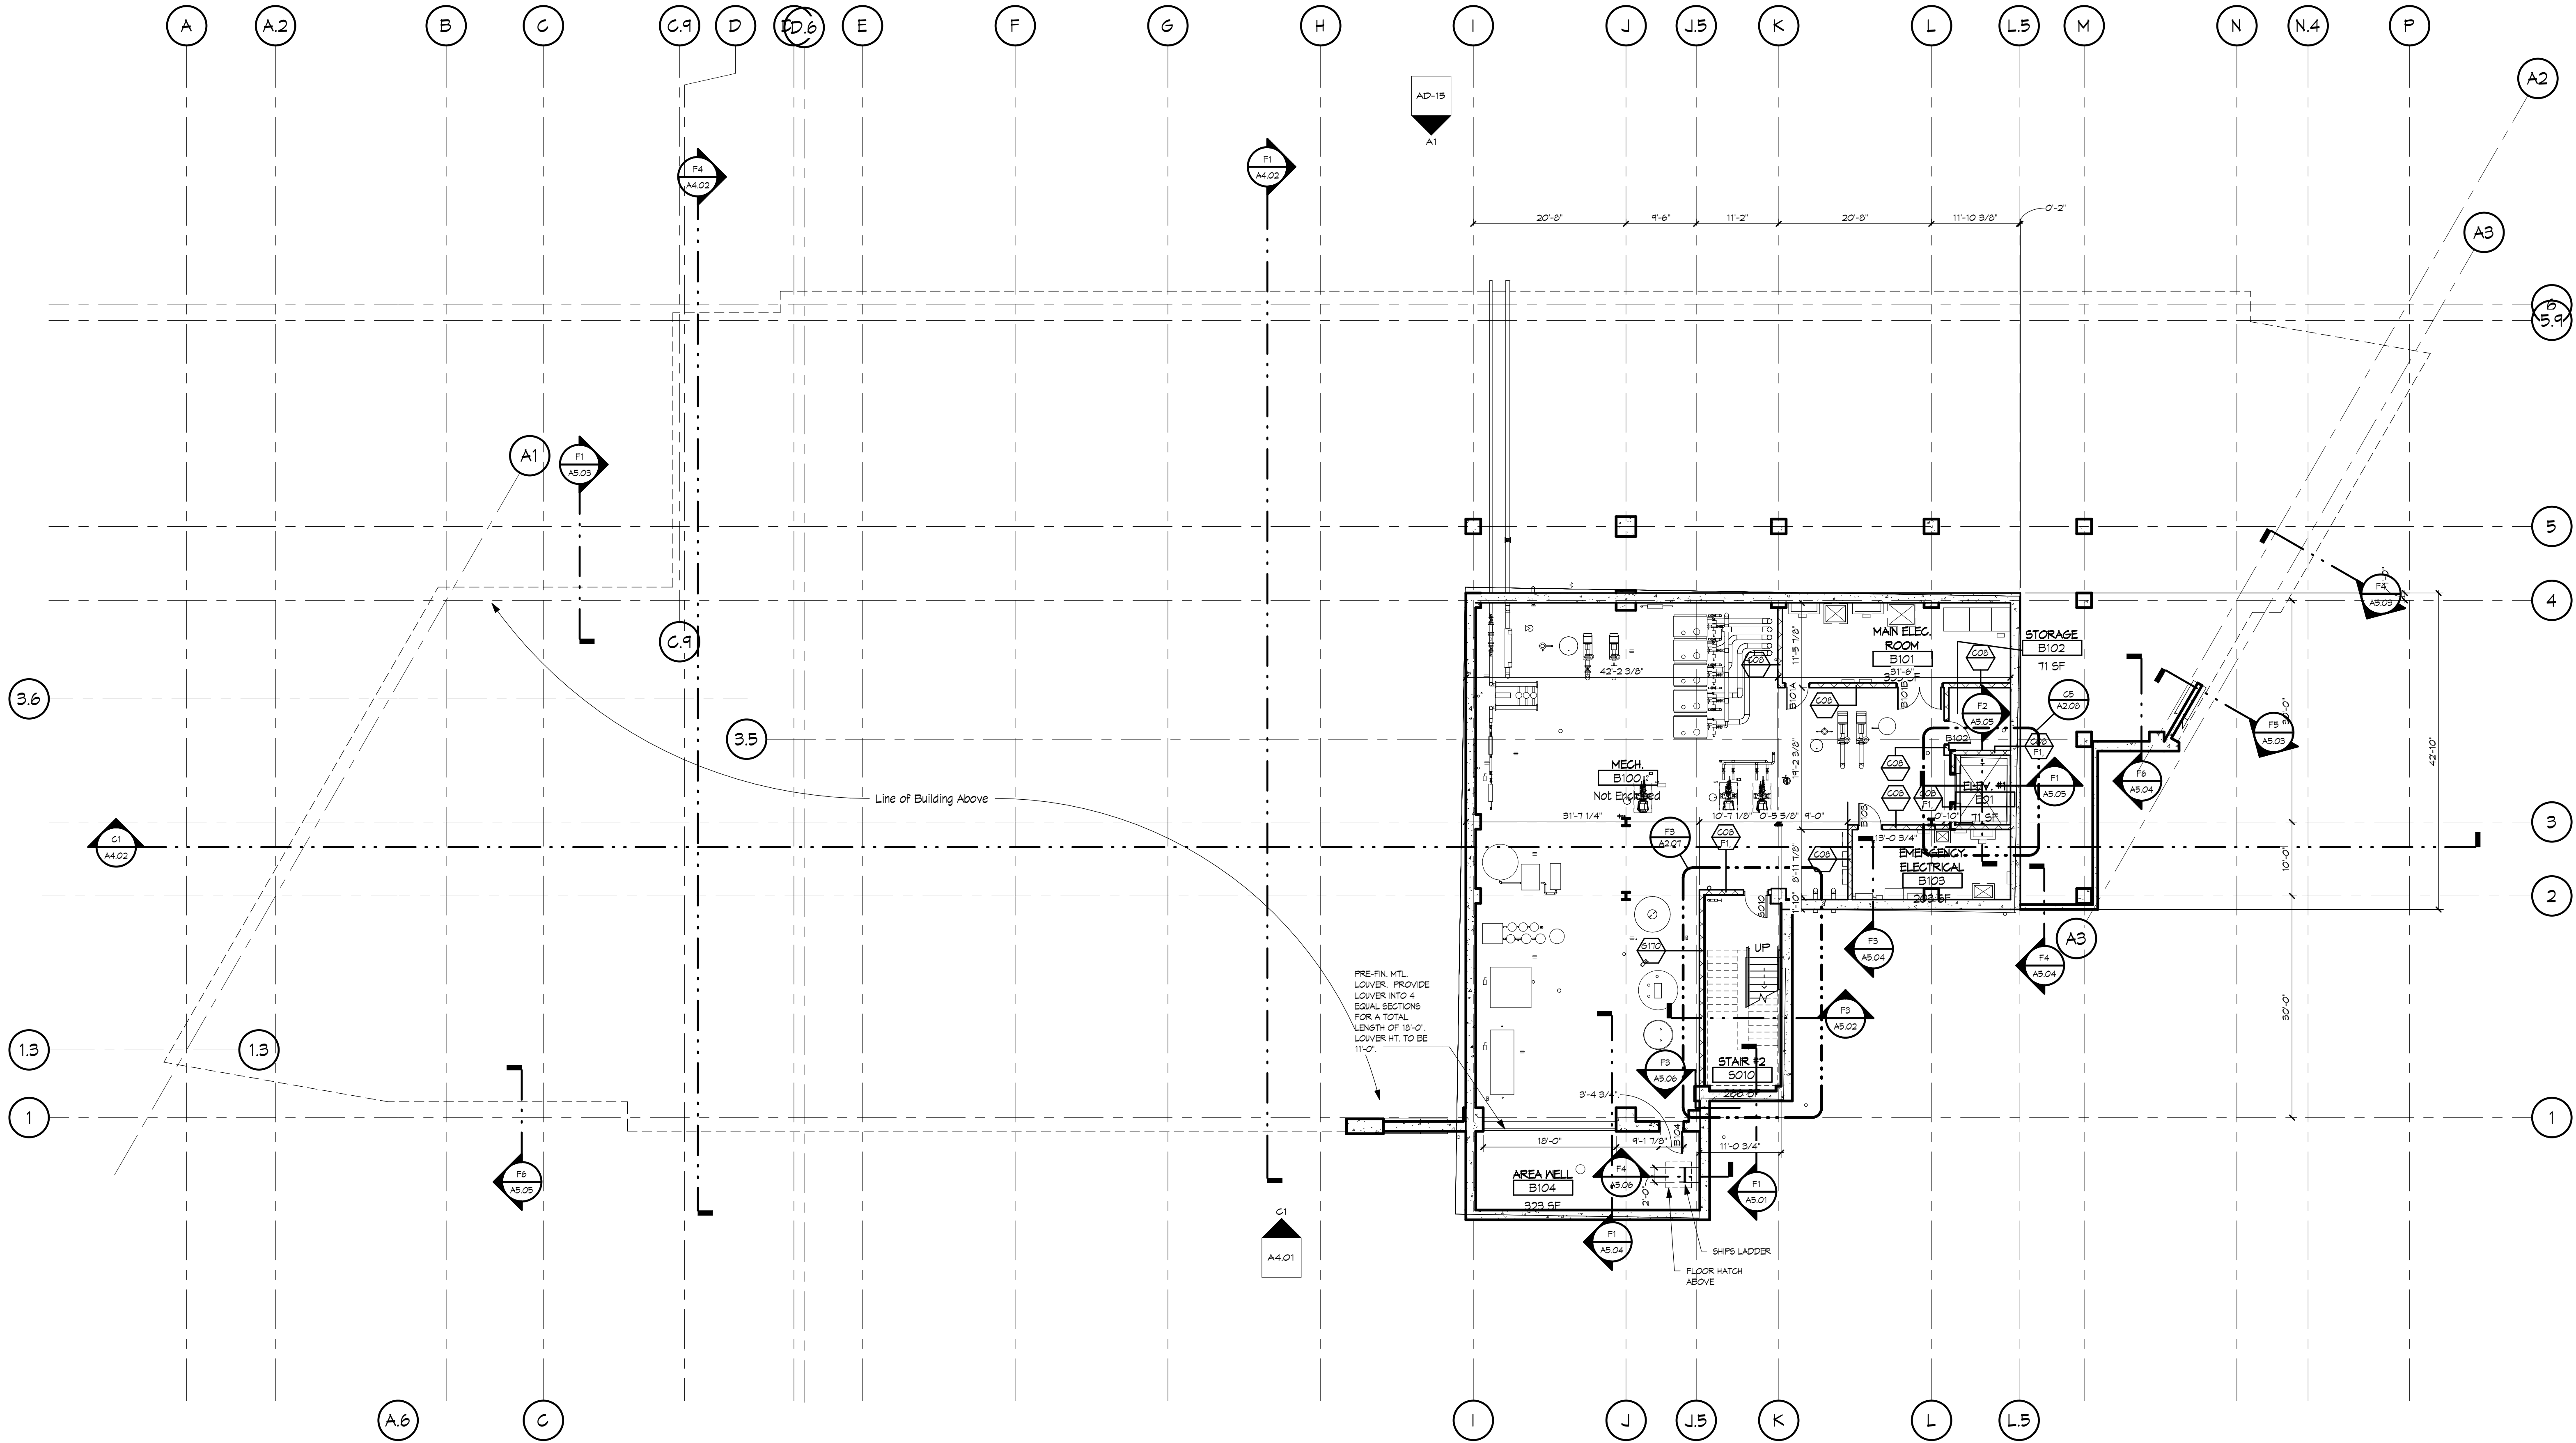

BASEMENT LEVEL DIM. PLAN

SCALE | 3/32" = 1'-0"

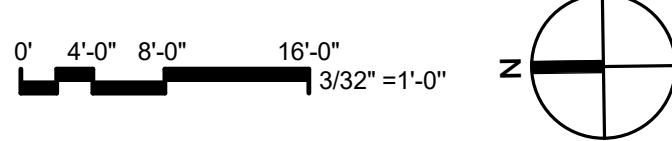

RECORD DRAWINGS: 12-04-17

REVISIONS	
RECORD COPY	Drawings are to be used only for the project shown on the sheet. No other use is permitted without the written consent of Hastings+Chivetta.
1	03-16-16

Date	03-16-16
Project Number	3100.00
Sheet Name	BASEMENT LEVEL DIM. PLAN
For Reference Only	

A2.01


Valparaiso University  
Science Laboratory Building- Phase One  
Valparaiso University | 1710 Chapel Drive | Valparaiso University | Valparaiso, IN 46383 | 219.464.5000

Hastings+Chivetta  
ARCHITECTURE • PLANNING • ENGINEERING  
219.464.5000 | 1710 Chapel Drive, Suite 100 | Valparaiso, IN 46383 | hchivetta.com  
CIVIL: DLZ 7011 Indianapolis Blvd., Hammond, IN 46324, (219) 845-1750  
STRUCTURAL: KJWW 623 26th Ave., Quind City, IL 61201, (309) 793-3431  
MEP: KJWW 623 26th Ave., Quind City, IL 61201, (309) 793-3431





C:\Users\collins\Documents\3100 Valpo Science Central\_2015\_collins\architects.com.rvt  
12/4/2017 8:52:23 AM

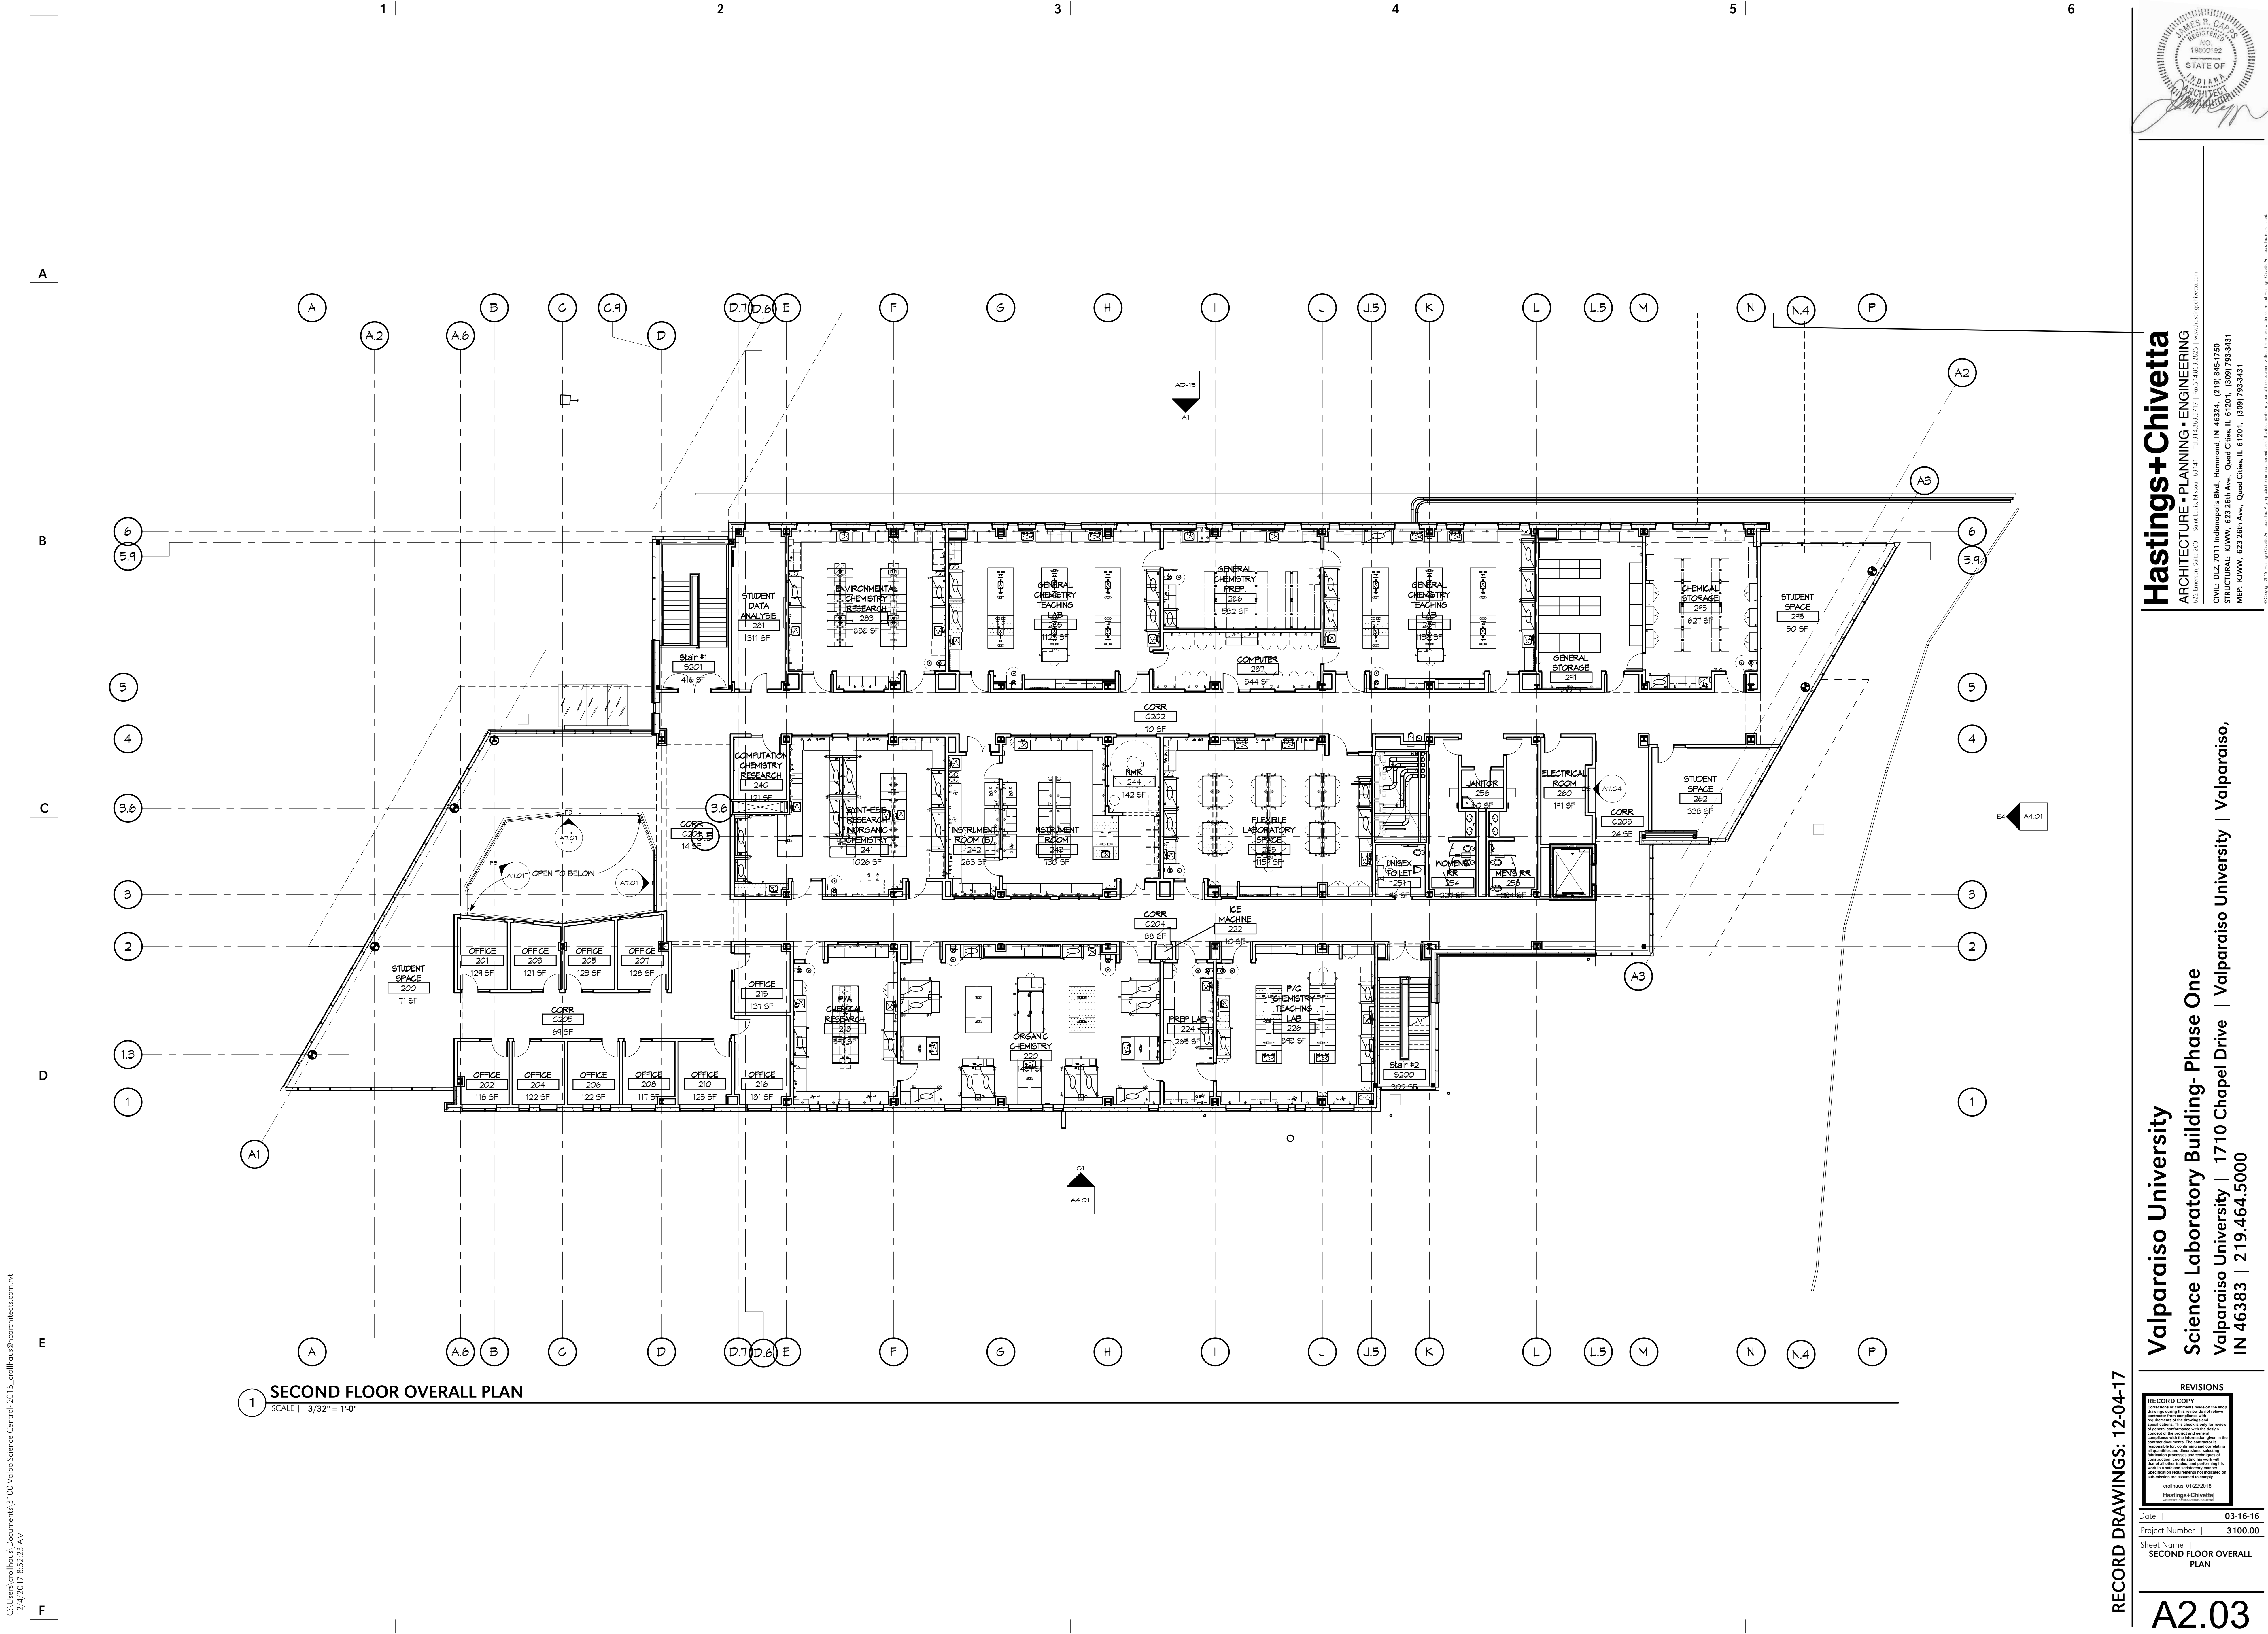

**Hastings+Chivetta**  
ARCHITECTURE • PLANNING • ENGINEERING  
222 West 10th Street, Suite 200 | Indianapolis, Indiana 46204 | Tel: 317.446.5771 | Fax: 317.446.5772 | Email: info@hastingschivetta.com  
CIVIL: 612.7011 Indianapolis Blvd., Hammond, IN 46324, (219) 845-1750  
STRUCTURAL: KWW, 623 26th Ave., Quind City, IL 61201, (309) 793-3431  
MEP: KWW, 623 26th Ave., Quind City, IL 61201, (309) 793-3431

**Valparaiso University**  
Science Laboratory Building- Phase One  
Valparaiso University | 1710 Chapel Drive | Valparaiso University | Valparaiso, IN 46383 | 219.464.5000

REVISIONS	
1	Revised for construction documents.
2	Revised for construction documents.
3	Revised for construction documents.
**A2.03**